PROPERTY ADDRESS 3400 NW 191 ST. MIAMI GARDENS, FL. 33056-2936 LOT BY THE VILLAGE AT MIAMI GARDENS. 4 52 41 3.34 AC M/L MIAMI GARDENS PB 2-96

SCOPE OF WORK: PROPOSED NEW 50u APARTMENT COMPLEX - BUILDING #6

E1/2 TR 77 LESS S25FT DF R/W & N265FT DF W1/2 DF TR 77 LESS


## **GENERAL NOTES:**


REGULATIONS HAVING JURISDICTION.

- ALL WORK IS TO BE DONE IN ACCORDANCE WITH THE FLORIDA BUILDING CODE 2017, 6TH EDITION
  AND ALL REGULATORY LOCAL AND GOVERNMENTAL CODES. CONTRACTOR SHALL VERIFY ALL DIMENSIONS AND CONDITIONS AND SHALL NOTIFY THE ARCHITECT IF ANY DISCREPANCIES ARE DISCOVERED BEFORE PROCEEDING WITH THE WORK.
- CONTRACTOR TO AQUIRE ALL REQUIRED PERMITS FOR THE CONSTRUCTION AND SUBSEQUENT OCCUPANCY OF THE PROJECT. . ALL WORK DONE UNDER THE SUPERVISION OF THE CONTRACTOR SHALL BE DONE IN A NEAT AND WORKMAN—LIKE MANNER AND IN ACCORDANCE WITH ALL GOVERNING AGENCIES, RULES AND
- 5. CONTRACTOR TO PROVIDE ALL SUPPLEMENTARY MATERIALS REQUIRED TO INSTALL, SUPPORT, BRACE AND SHORE ALL BUILDING COMPONENTS.
- PRIOR TO COMMENCING WORK, THE CONTRACTOR SHALL VERIFY THE LOCATION OF ALL EQUIPMENT AND UTILITIES TO BE REMOVED. REMOVALS SHALL BE COORDINATED WITH THE OWNER AND ALL BUILDING AUTHORITIES HAVING JURISDICTION. 7. CONTRACTOR SHALL PROVIDE THE ARCHITECT WITH RED-LINED AS-BUILT DRAWINGS FOR ANY AND ALL FIELD CHANGES AND/OR ADDITIONS TO THE WORK INCLUDING IN THE DRAWINGS.
- 8. IF ANY CHANGES AND/OR DEVIATIONS ARE MADE TO THESE PLANS WITHOUT THE WRITTEN AUTHORIZATION OF THE ARCHITECT.
  THE CONTRACTOR SHALL BEAR FULL RESPONSIBILITY FOR SUCH CHANGES AND/OR DEVIATIONS.
- . IF DURING THE COURSE OF CONSTRUCTION ANY DEVIATIONS ARE MADE AT THE FIELD, AGAIN, THE CONTRACTOR SHALL BEAR FULL RESPONSIBILITY FOR SUCH CHANGES AND DEVIATIONS.
- 10. ALL SHOP DRAWINGS SHALL BE SUBMITTED TO THE ARCHITECT FOR DESIGN CONFORMANCE ONLY. 11. SUBSTITUTIONS MUST BE REVIEWED AND APPROVED BY THE ARCHITECT OR ENGINEERS.
- 12. CONTRACTOR OR SUB—CONTRACTOR SHALL BE RESPONSIBLE FOR CLEANING HIS OPERATION AND ANY DAMAGE TO HIS WORK WHILE PROJECT IS UNDER CONSTRUCTION.
- 13. ALL DESIGNS AND DRAWINGS HEREIN AND PRINTS ISSUED BY THE ARCHITECT ARE THE PROPERTY OF THE ARCHITECT AND SHALL NOT BE REUSED ON ANY OTHER LOCATION EXCEPT
  WHERE THE ONE FOR WHICH THEY WERE EXPRESSLY DESIGNED
  IF THESE DRAWINGS OR ANY PART THERE OF IS REPRODUCED
  WITHOUT THE CONSENT OF THE ARCHITECT, THE PERSON SO
  DOING WILL BE INDEBTED TO ARCHITECT FOR HIS FULL
  COMMISSION

\* SEE SHEET ATTACHED SCHEMATIC FIRE SPRINKLER PLANS HAVE BEEN

PROVIDED ON FS-1 AND FS-2. FOR COMPLETE FIRE SPRINKLER DRAWINGS PLEASE SEE S&S SHOP DRAWING ATTACHED UNDER SEPARATE PERMIT

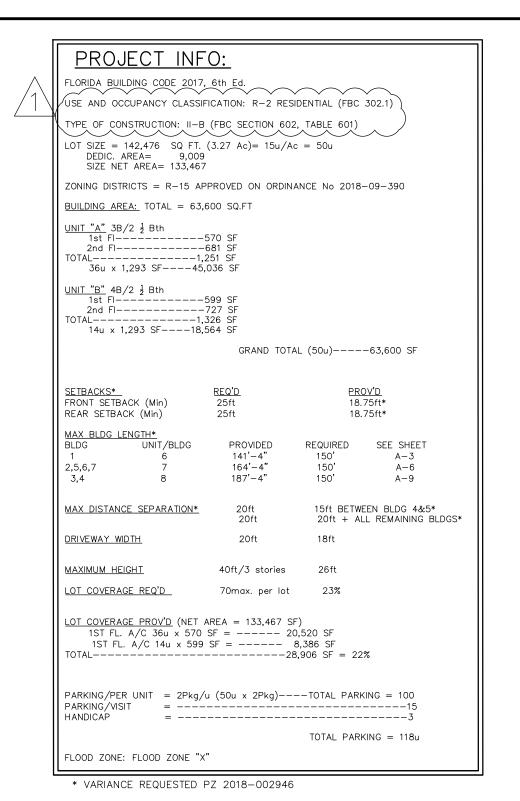

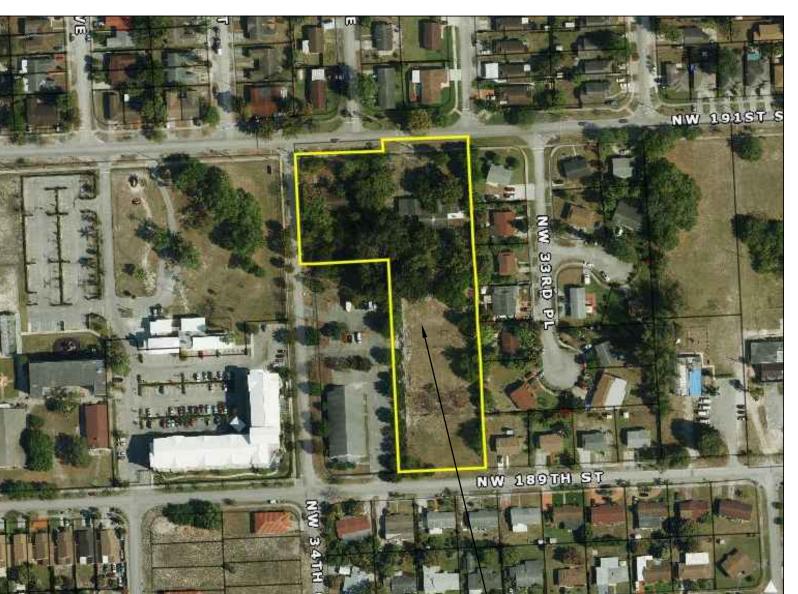

SUBJECT PROPERTY


## LOCATION PLAN SCALE: N.T.S.



A-100 09252019.pdf Examiner <u>Disp.</u> <u>Trade</u> Date Time Stamp Ron Bennett 11/13/2019 9:38:33 AMR Mayra De Torres 11/5/2019 10:05:43 AMA DERM Paving and Drainage

3419015772 - 11/14/2019 12:33:16 PM

SUBJECT PROPERTY

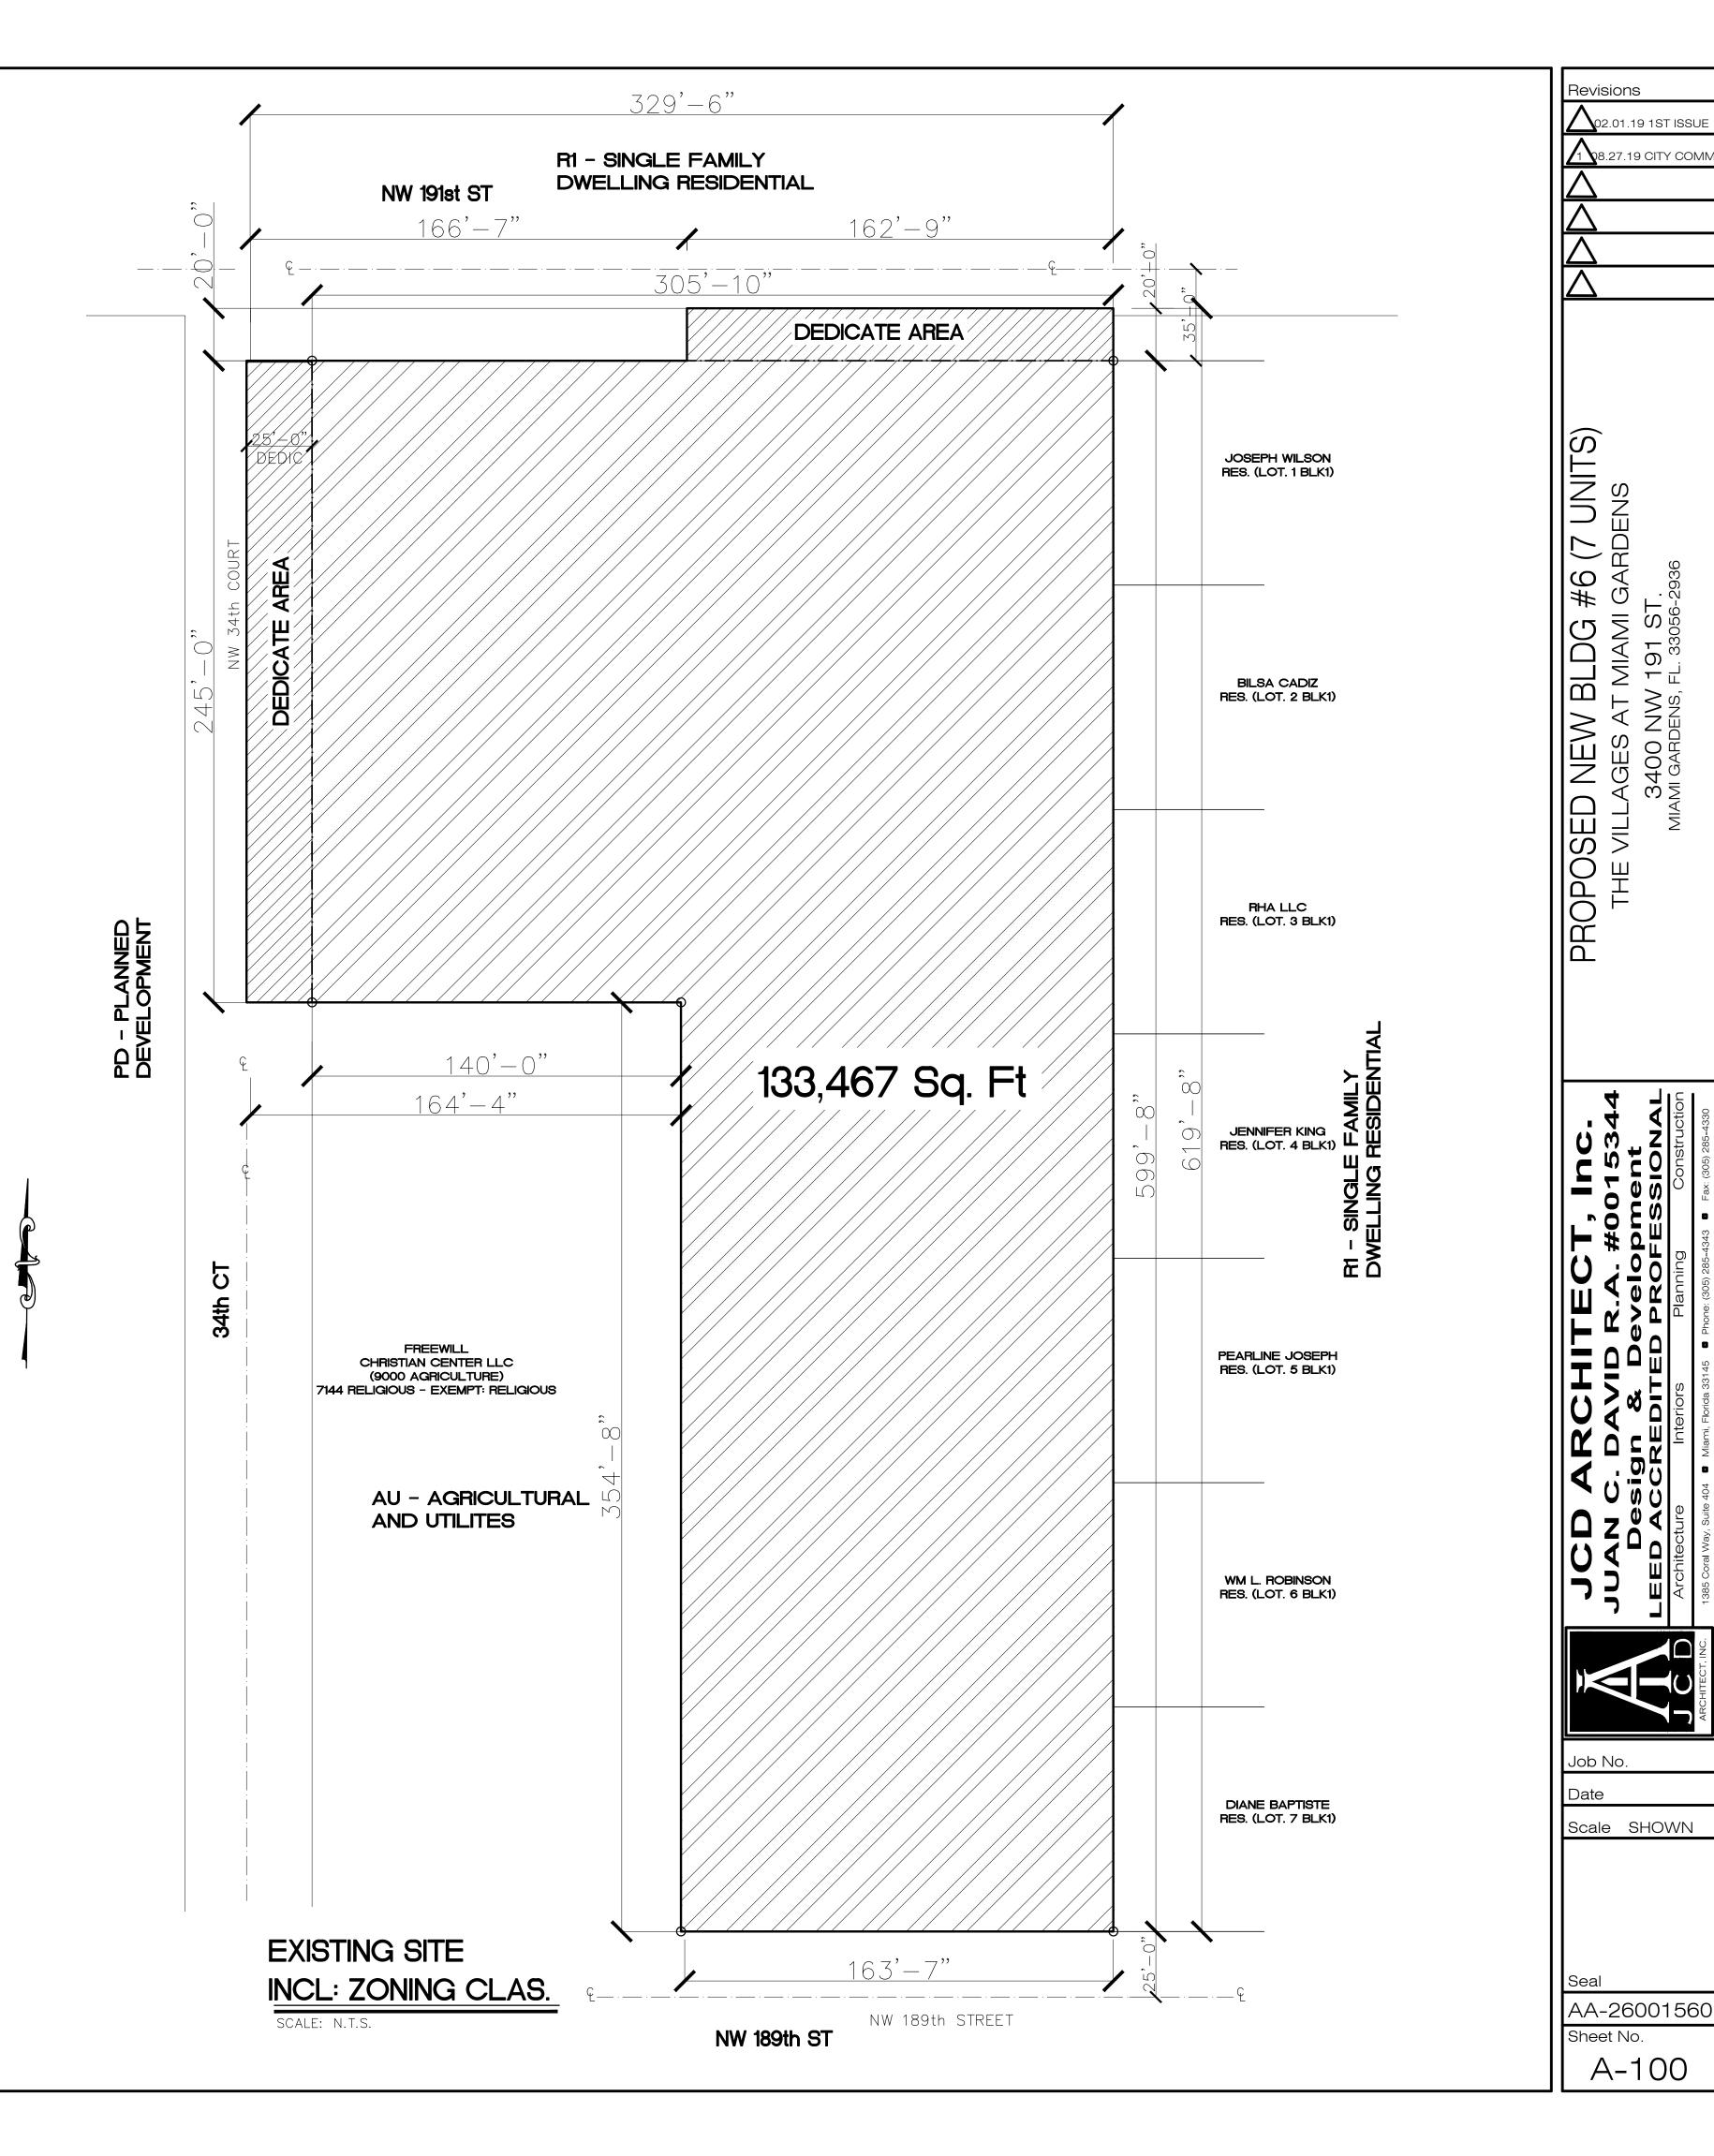

Stion .